


# Mc CLOUD CONDOMINIUMS A CONDOMINIUM DEVELOPMENT

## 1<sup>st</sup> FLOOR UNITS

NOTE: UNITS 33,35,43,44,57,59  
ARE SHOWN AS BUILT.  
THEY DO NOT CONFORM  
TO OFFICIAL PLAT.

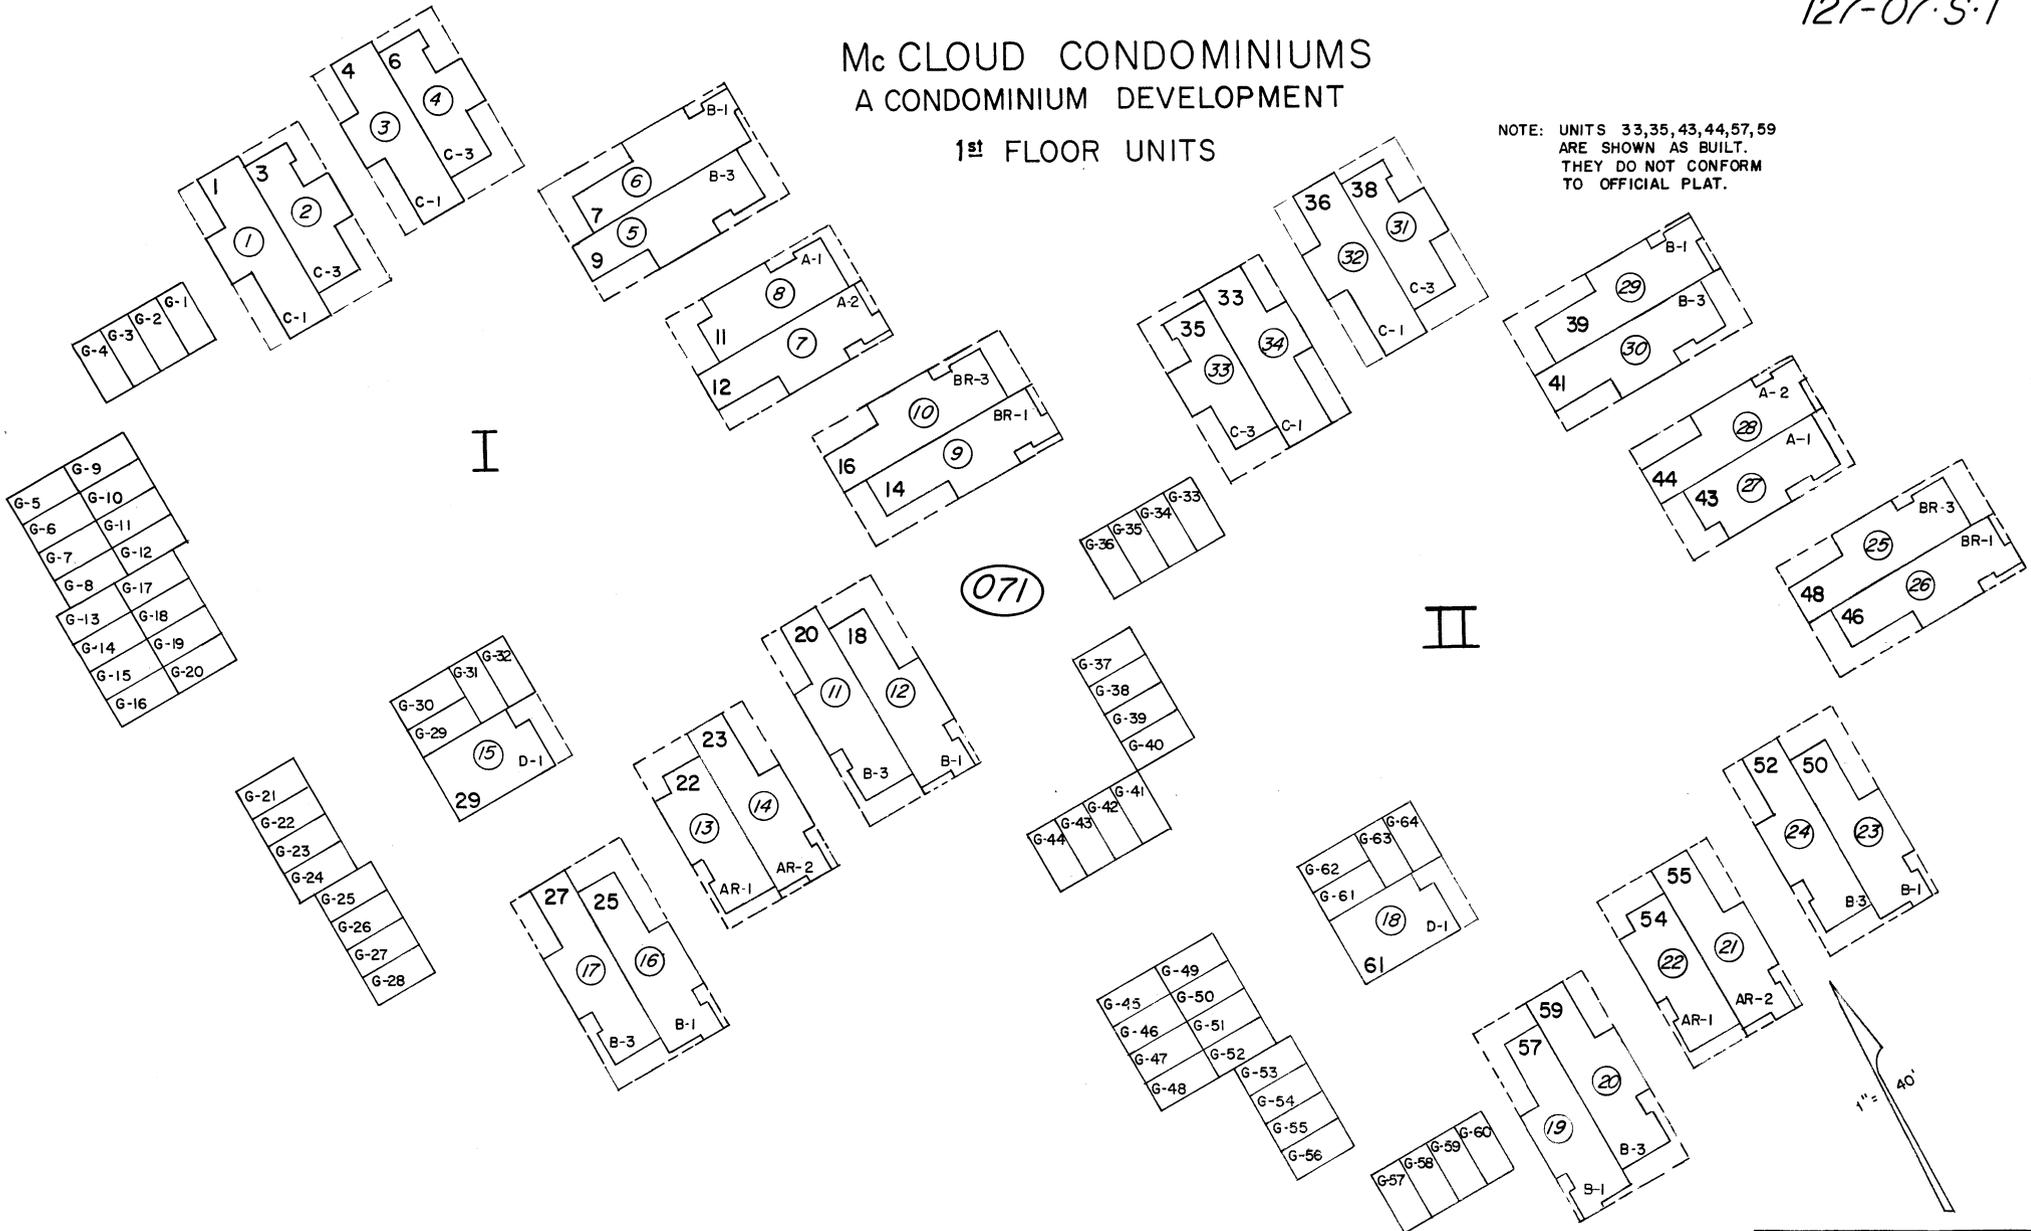

NOTE: This Map is prepared for the use of the Washoe County Assessor for Assessment and illustrative purposes only. It does not represent a survey of the premises. No liability is assumed as to the sufficiency or accuracy of the data delineated hereon.

Assessor's Map County of Washoe, Nevada

NOTE - ASSESSOR'S BLOCK NUMBERS SHOWN IN ELLIPSES  
ASSESSOR'S PARCEL NUMBERS SHOWN IN CIRCLES

drawn by MARY CRAIG 3/80
revised 6/88
superseded