


# Mc CLOUD CONDOMINIUMS A CONDOMINIUM DEVELOPMENT 2<sup>nd</sup> & 3<sup>rd</sup> FLOOR UNITS

NOTE: UNITS 75, 77, 82, 84, 86, 88, 90, 92  
ARE SHOWN AS BUILT.  
THEY DO NOT CONFORM  
TO OFFICIAL PLAT.

3<sup>rd</sup> FLOOR

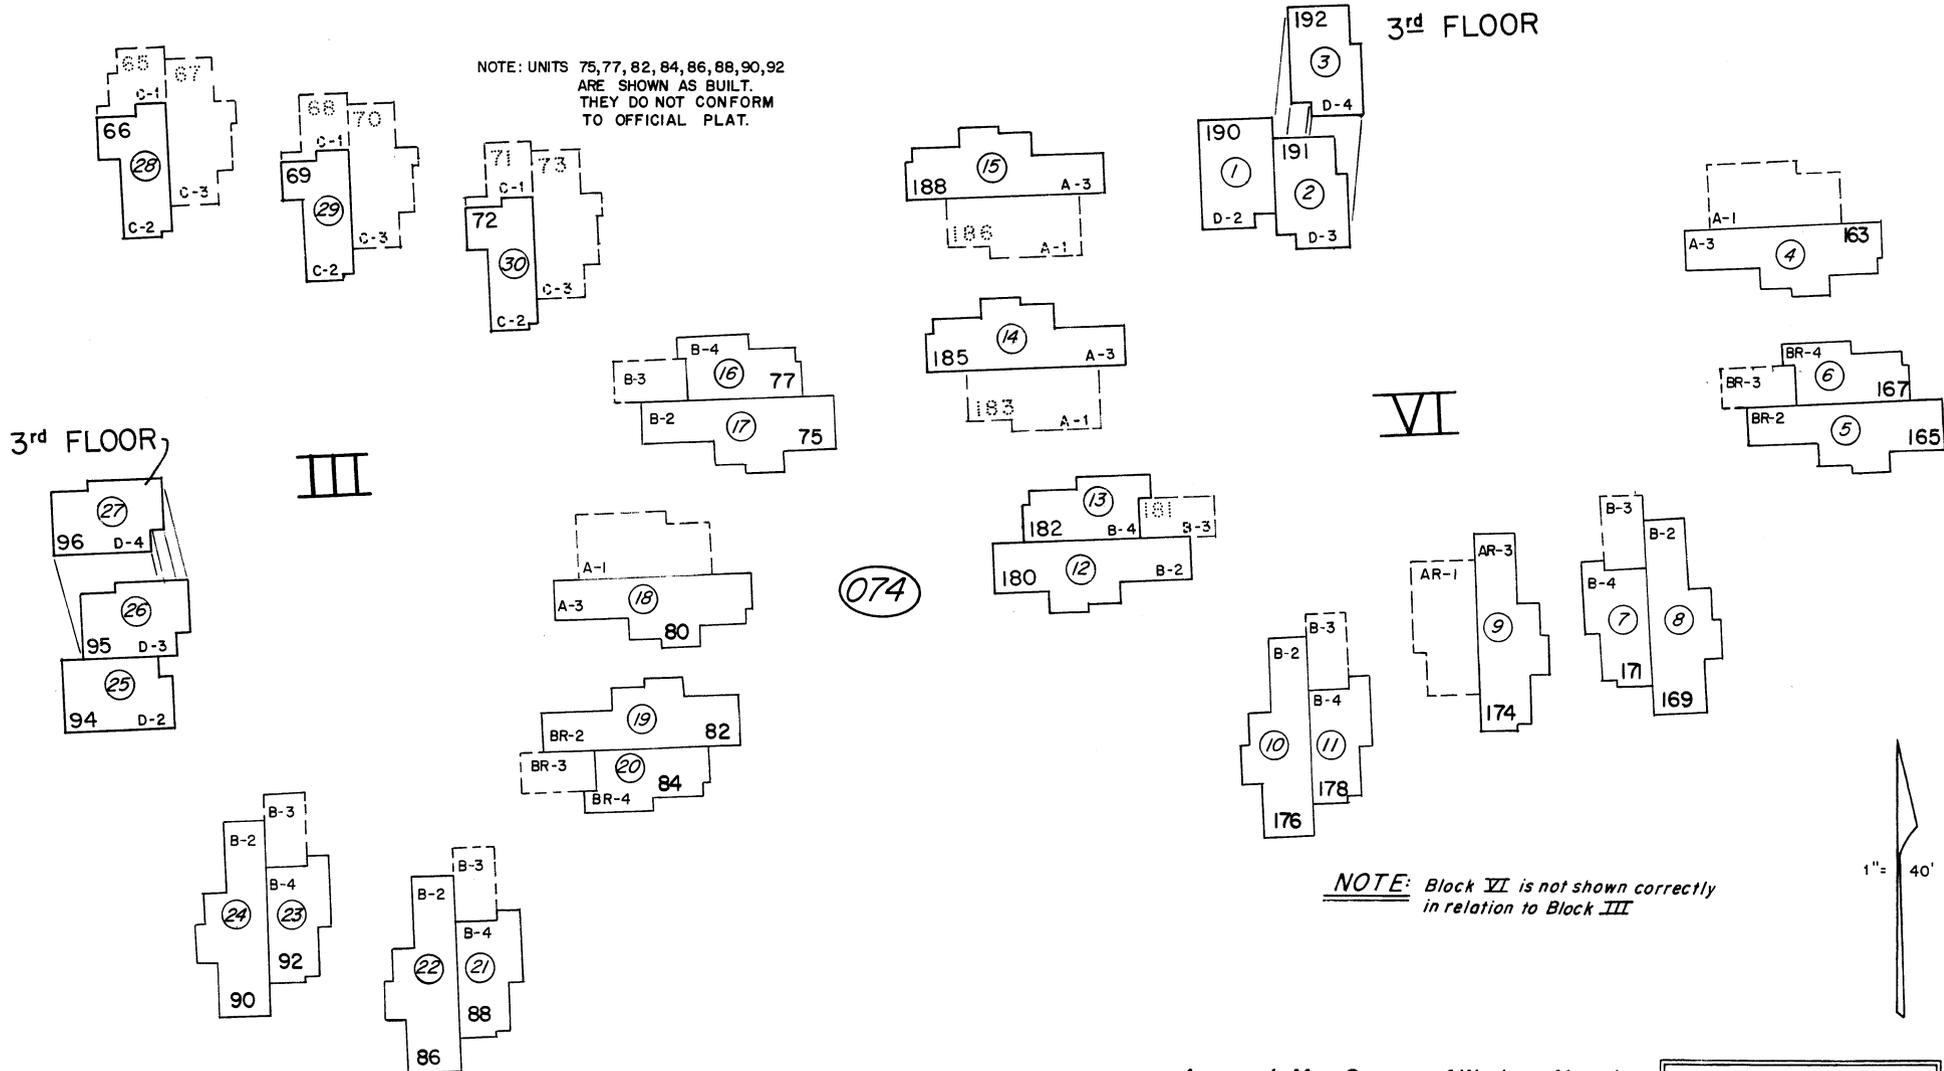

NOTE: Block VII is not shown correctly  
in relation to Block III

NOTE: This Map is prepared for the use of the Washoe County Assessor for Assessment and illustrative purposes only, it does not represent survey of the premises. No liability is assumed as to the sufficiency or accuracy of the data delineated hereon.

Assessor's Map County of Washoe, Nevada

NOTE - ASSESSOR'S BLOCK NUMBERS SHOWN IN ELLIPSES  
ASSESSOR'S PARCEL NUMBERS SHOWN IN CIRCLES

drawn by	MARY CRAIG 3/80
revised	2/88
superseded	